



Upper Occoquan Service Authority

Leader in Water Reclamation and Reuse

14631 COMPTON ROAD, CENTREVILLE, VIRGINIA 20121-2506
(703) 830-2200

TO ALL RFP RECIPIENTS:

For UOSA RFP 24-15 Furnish and Deliver Gas Booster

SUBJECT: Addendum # 1

The above numbered solicitation is amended as set forth below. The hour and date specified for receipt of offers:

☒ is not extended

☐ is extended

OFFERORS MUST ACKNOWLEDGE receipt of this Addendum by one of the following methods:

- a. By acknowledgement of this Addendum on Submission Form submitted with the proposal;
- b. By referencing its receipt in your Transmittal Letter

If by virtue of this Addendum you desire to change a proposal already submitted, such change may be made by letter, provided it includes reference to the solicitation and this Addendum and is received prior to the due hour and date specified.

DESCRIPTION OF ADDENDUM:

To provide drawings that were unintentionally omitted from RFP 24-15.

The following two drawings attached to this addendum shall be incorporated into RFP 24-15.

All other Terms, Conditions, Tables, Charts and Specifications, and Drawings not otherwise changed remain as originally stated or as shown.

ISSUED BY:


Upper Occoquan Service Authority


A handwritten signature in blue ink, appearing to read 'Dustin Baker', is written over a horizontal line.

05/03/2024






Dustin Baker, Senior Buyer

Date

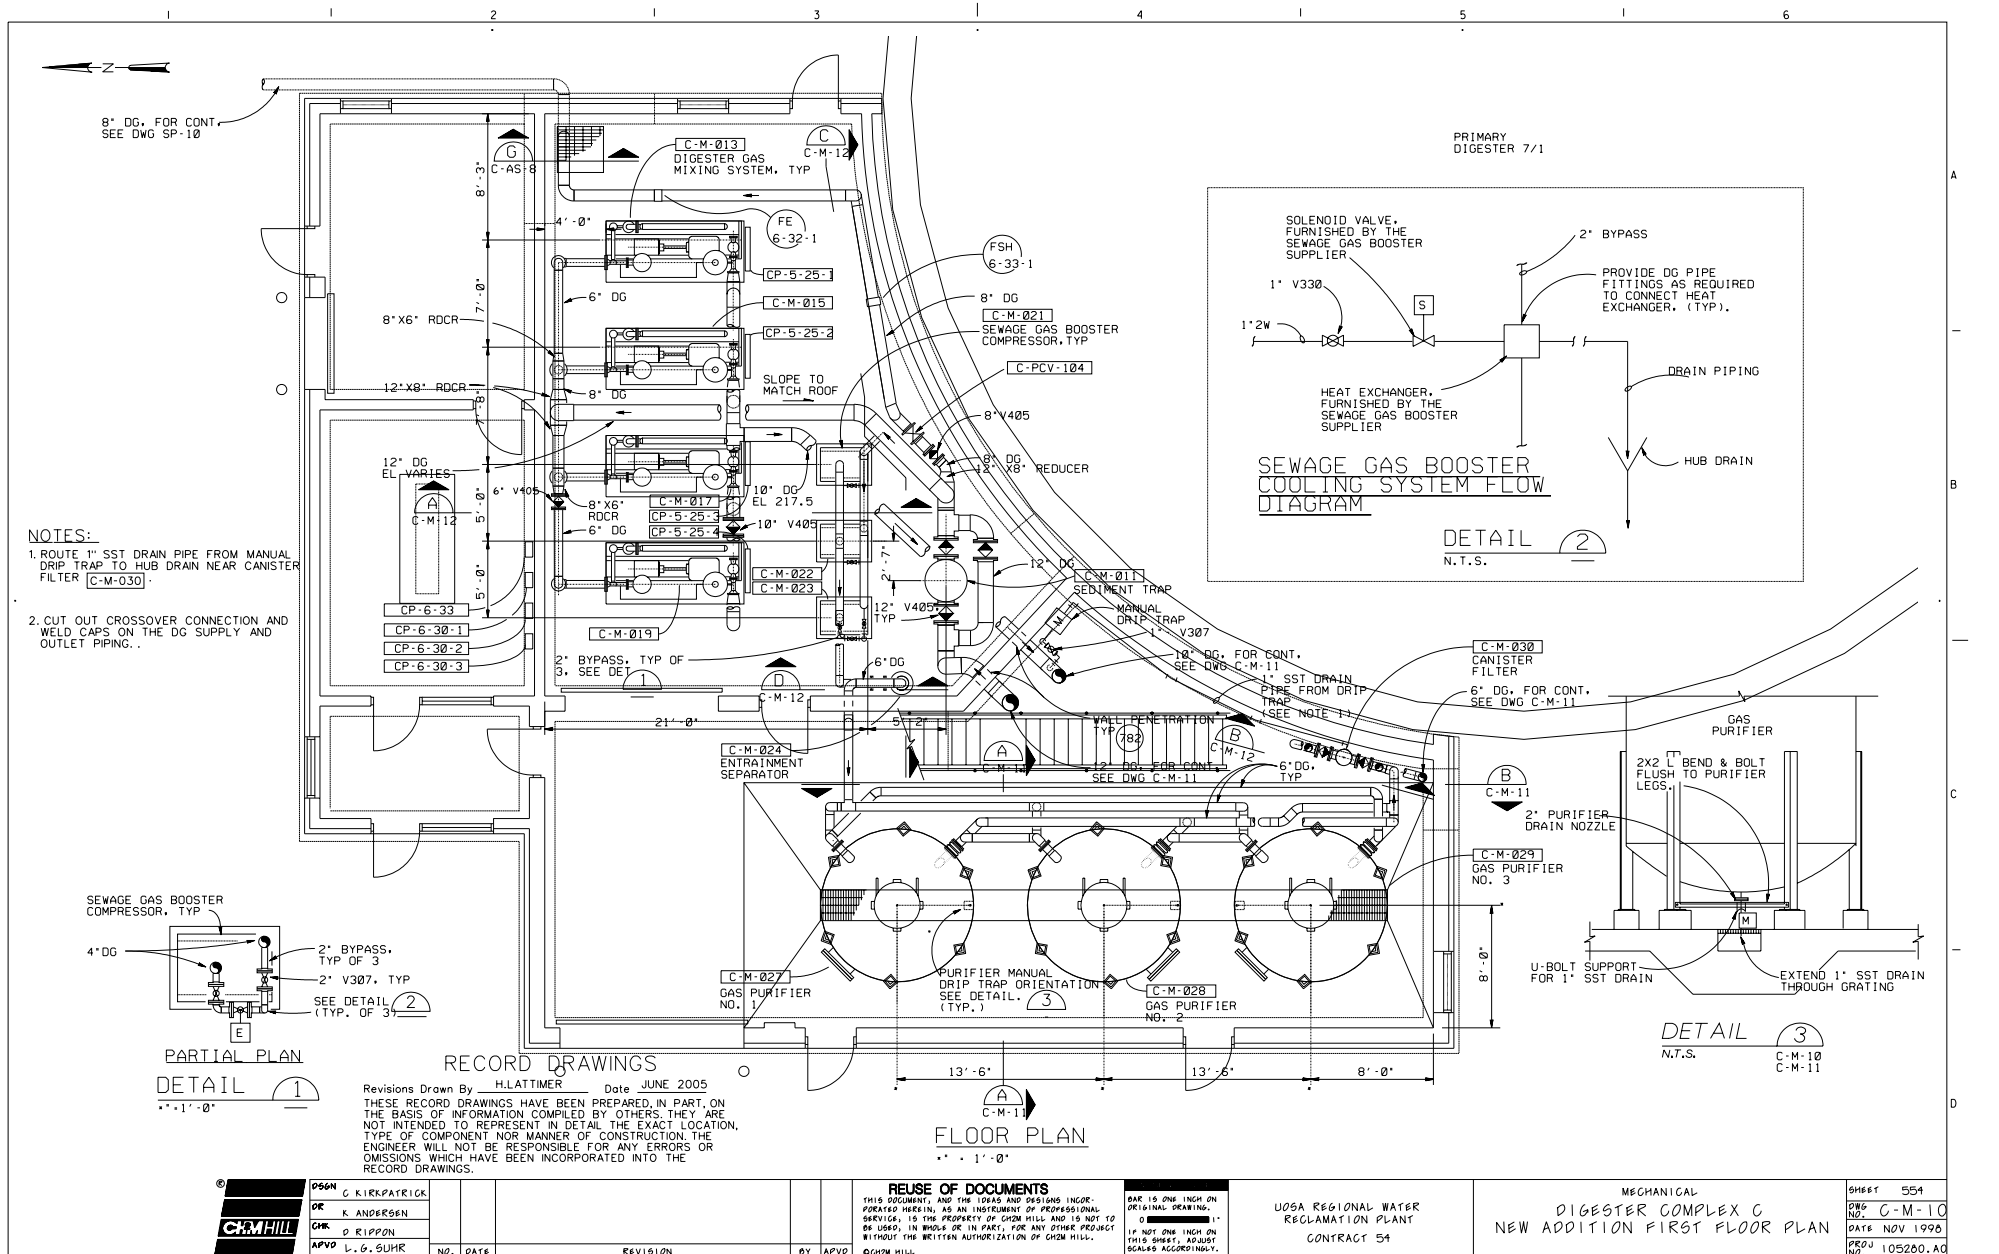

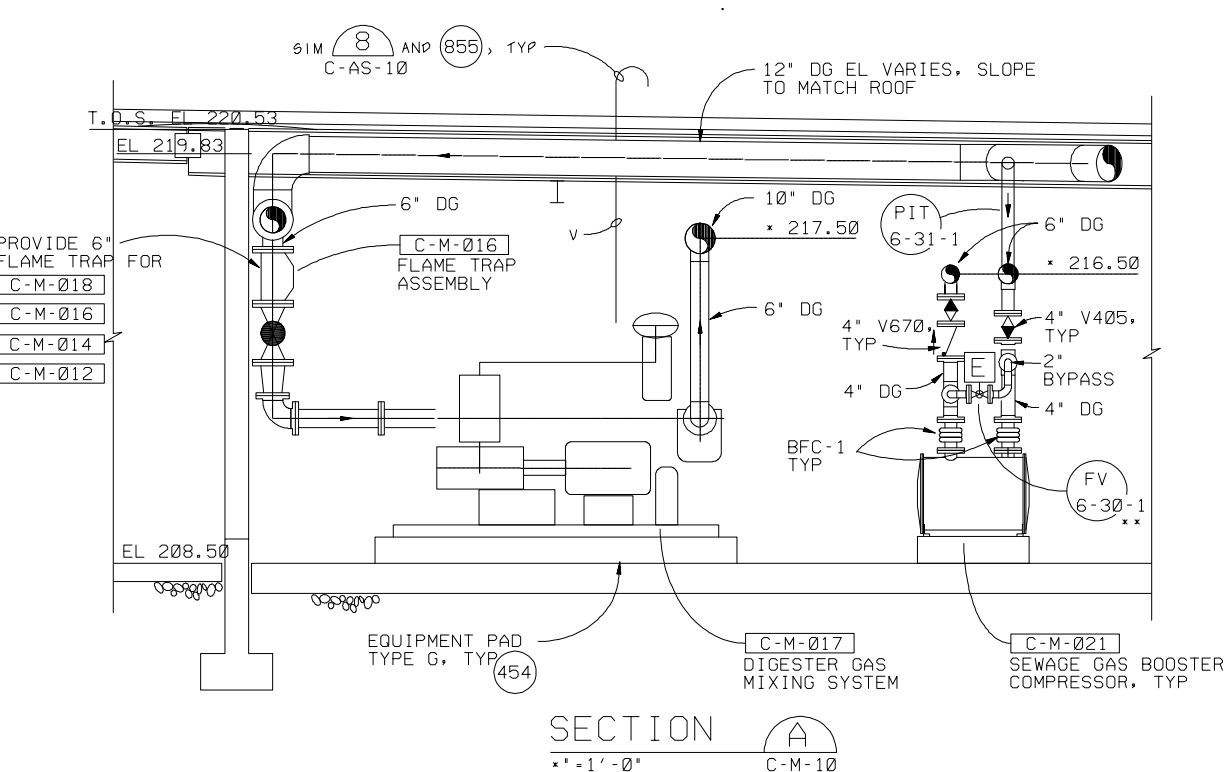

THE CONSTRUCTION SHOWN FOR EXISTING PORTIONS OF BUILDING C AND DIGESTER 7/2 WAS PARTIALLY COMPLETED UNDER THIS CONTRACT PRIOR TO TERMINATION OF THE CONTRACTOR. THE DRAWINGS SHOW THE INTENDED CONSTRUCTION AT THE TIME OF CONTRACT 54 FOR RECORD PURPOSES, BUT DO NOT REFLECT THE PARTIALLY COMPLETED STATE OF THE CONSTRUCTION AT THE TIME OF TERMINATION OF THE CONTRACTOR. THE CONSTRUCTION WAS REVISED AND ULTIMATELY COMPLETED UNDER UOSA CONTRACT 8/1 FOLLOWING THE PREPARATION OF THESE RECORD DRAWINGS. SEE RECORD DRAWINGS FOR UOSA CONTRACT 8/1 FOR THE RECORD OF THE REVISED COMPLETED CONSTRUCTION INCLUDING ADDITIONAL MODIFICATIONS TO DIGESTER 8/1.

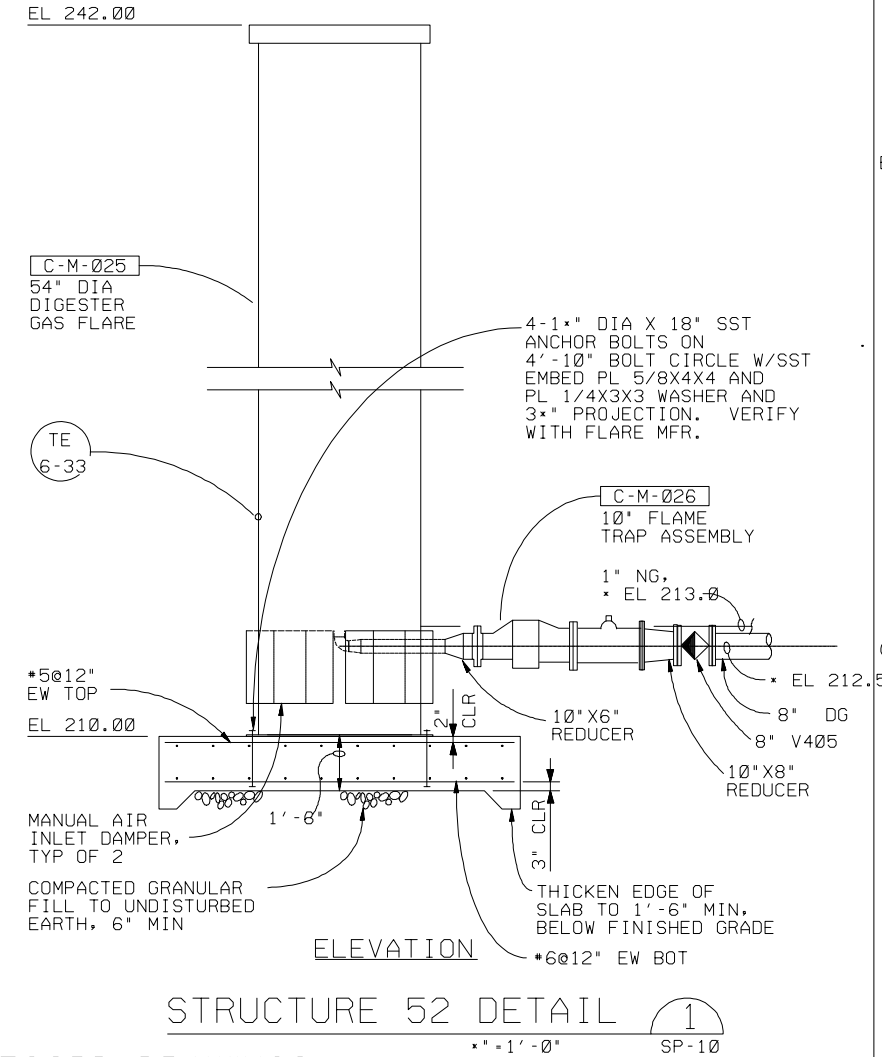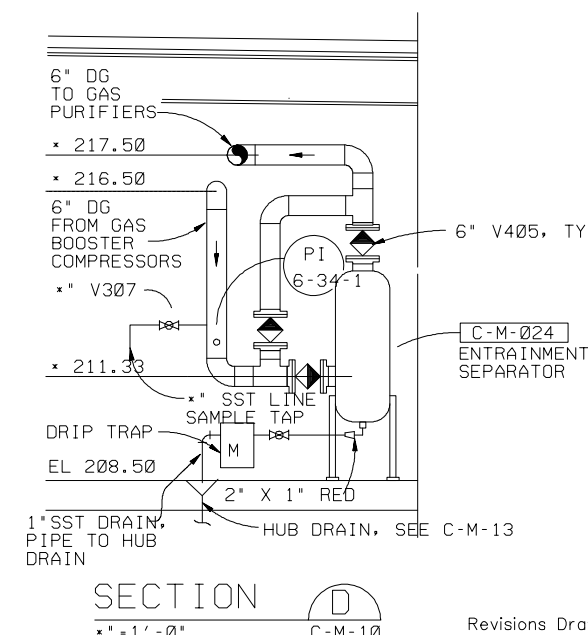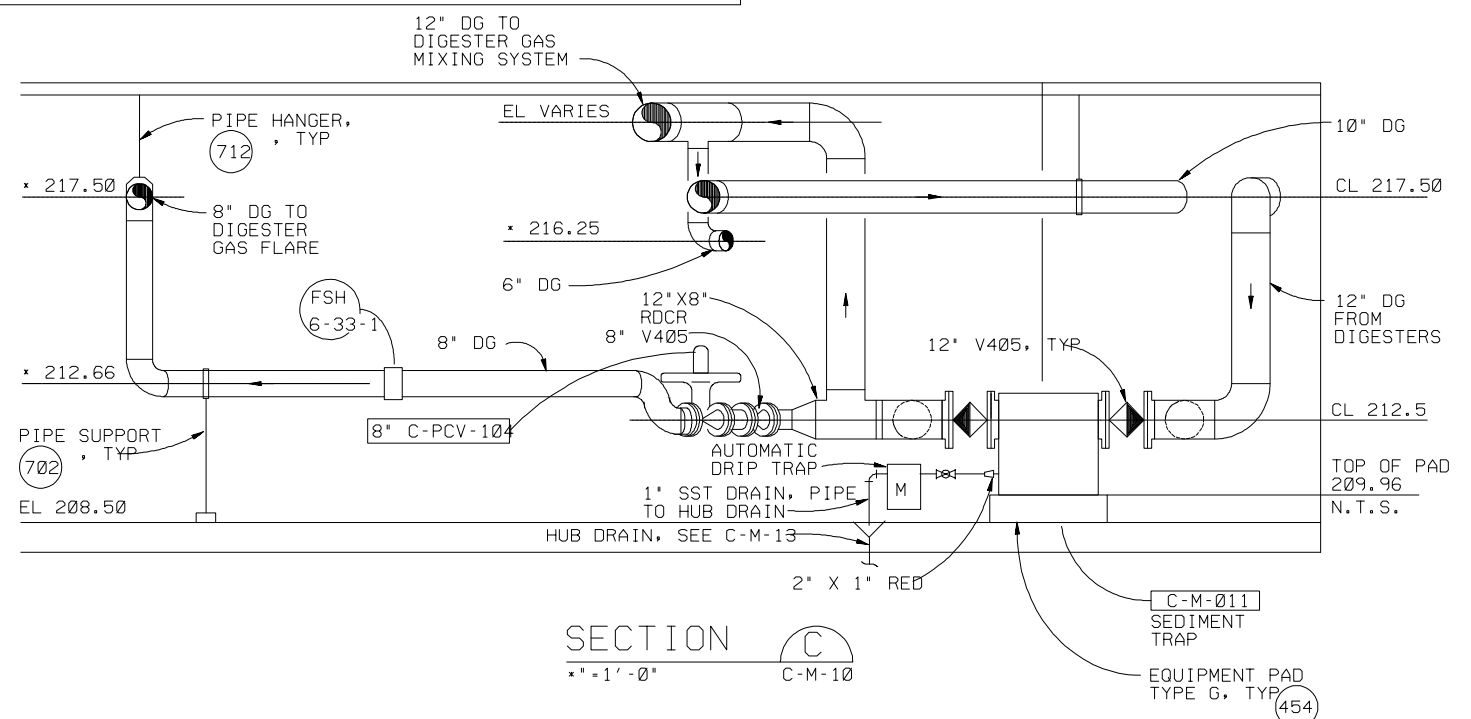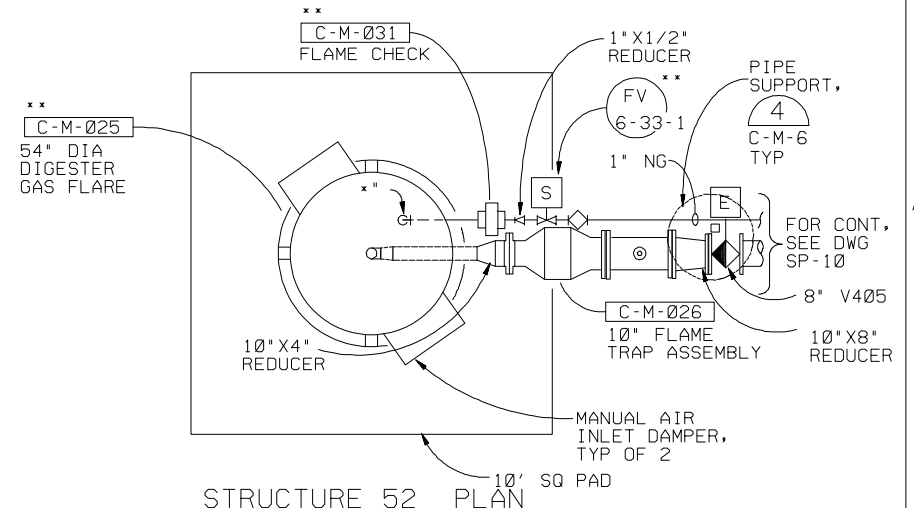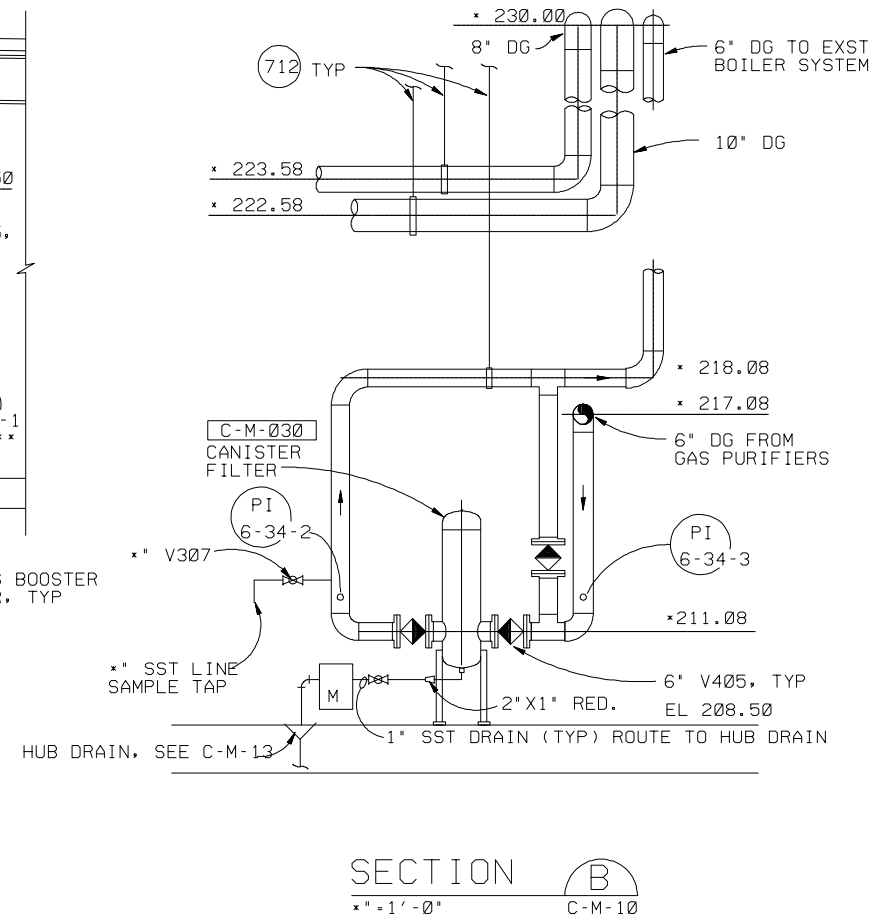

RECORD DRAWINGS

Revisions Drawn By H.LATTIMER Date JUNE 2005
 THESE RECORD DRAWINGS HAVE BEEN PREPARED, IN PART, ON THE BASIS OF INFORMATION COMPILED BY OTHERS. THEY ARE NOT INTENDED TO REPRESENT IN DETAIL THE EXACT LOCATION, TYPE OF COMPONENT NOR MANNER OF CONSTRUCTION. THE ENGINEER WILL NOT BE RESPONSIBLE FOR ANY ERRORS OR OMISSIONS WHICH HAVE BEEN INCORPORATED INTO THE RECORD DRAWINGS.



DESIGN	C KIRKPATRICK				
DR	K ANDERSEN				
CHK	D RIPPON				
APVD	L.G. SUHR	NO.	DATE	REVISION	BY

REUSE OF DOCUMENTS
 THIS DOCUMENT, AND THE IDEAS AND DESIGNS INCORPORATED HEREIN, AS AN INSTRUMENT OF PROFESSIONAL SERVICE, IS THE PROPERTY OF CH2M HILL AND IS NOT TO BE USED, IN WHOLE OR IN PART, FOR ANY OTHER PROJECT WITHOUT THE WRITTEN AUTHORIZATION OF CH2M HILL.

VERIFY SCALE
 BAR IS ONE INCH ON ORIGINAL DRAWING.
 0 1'
 IF NOT ONE INCH ON THIS SHEET, ADJUST SCALES ACCORDINGLY.

UOSA REGIONAL WATER RECLAMATION PLANT
 CONTRACT 54

MECHANICAL
 DIGESTER COMPLEX C
 NEW ADDITION
 SECTIONS & DETAIL

SHEET	556
DWG NO.	C-M-12
DATE	NOV 1998
PROJ NO.	105280.A0